


34
148

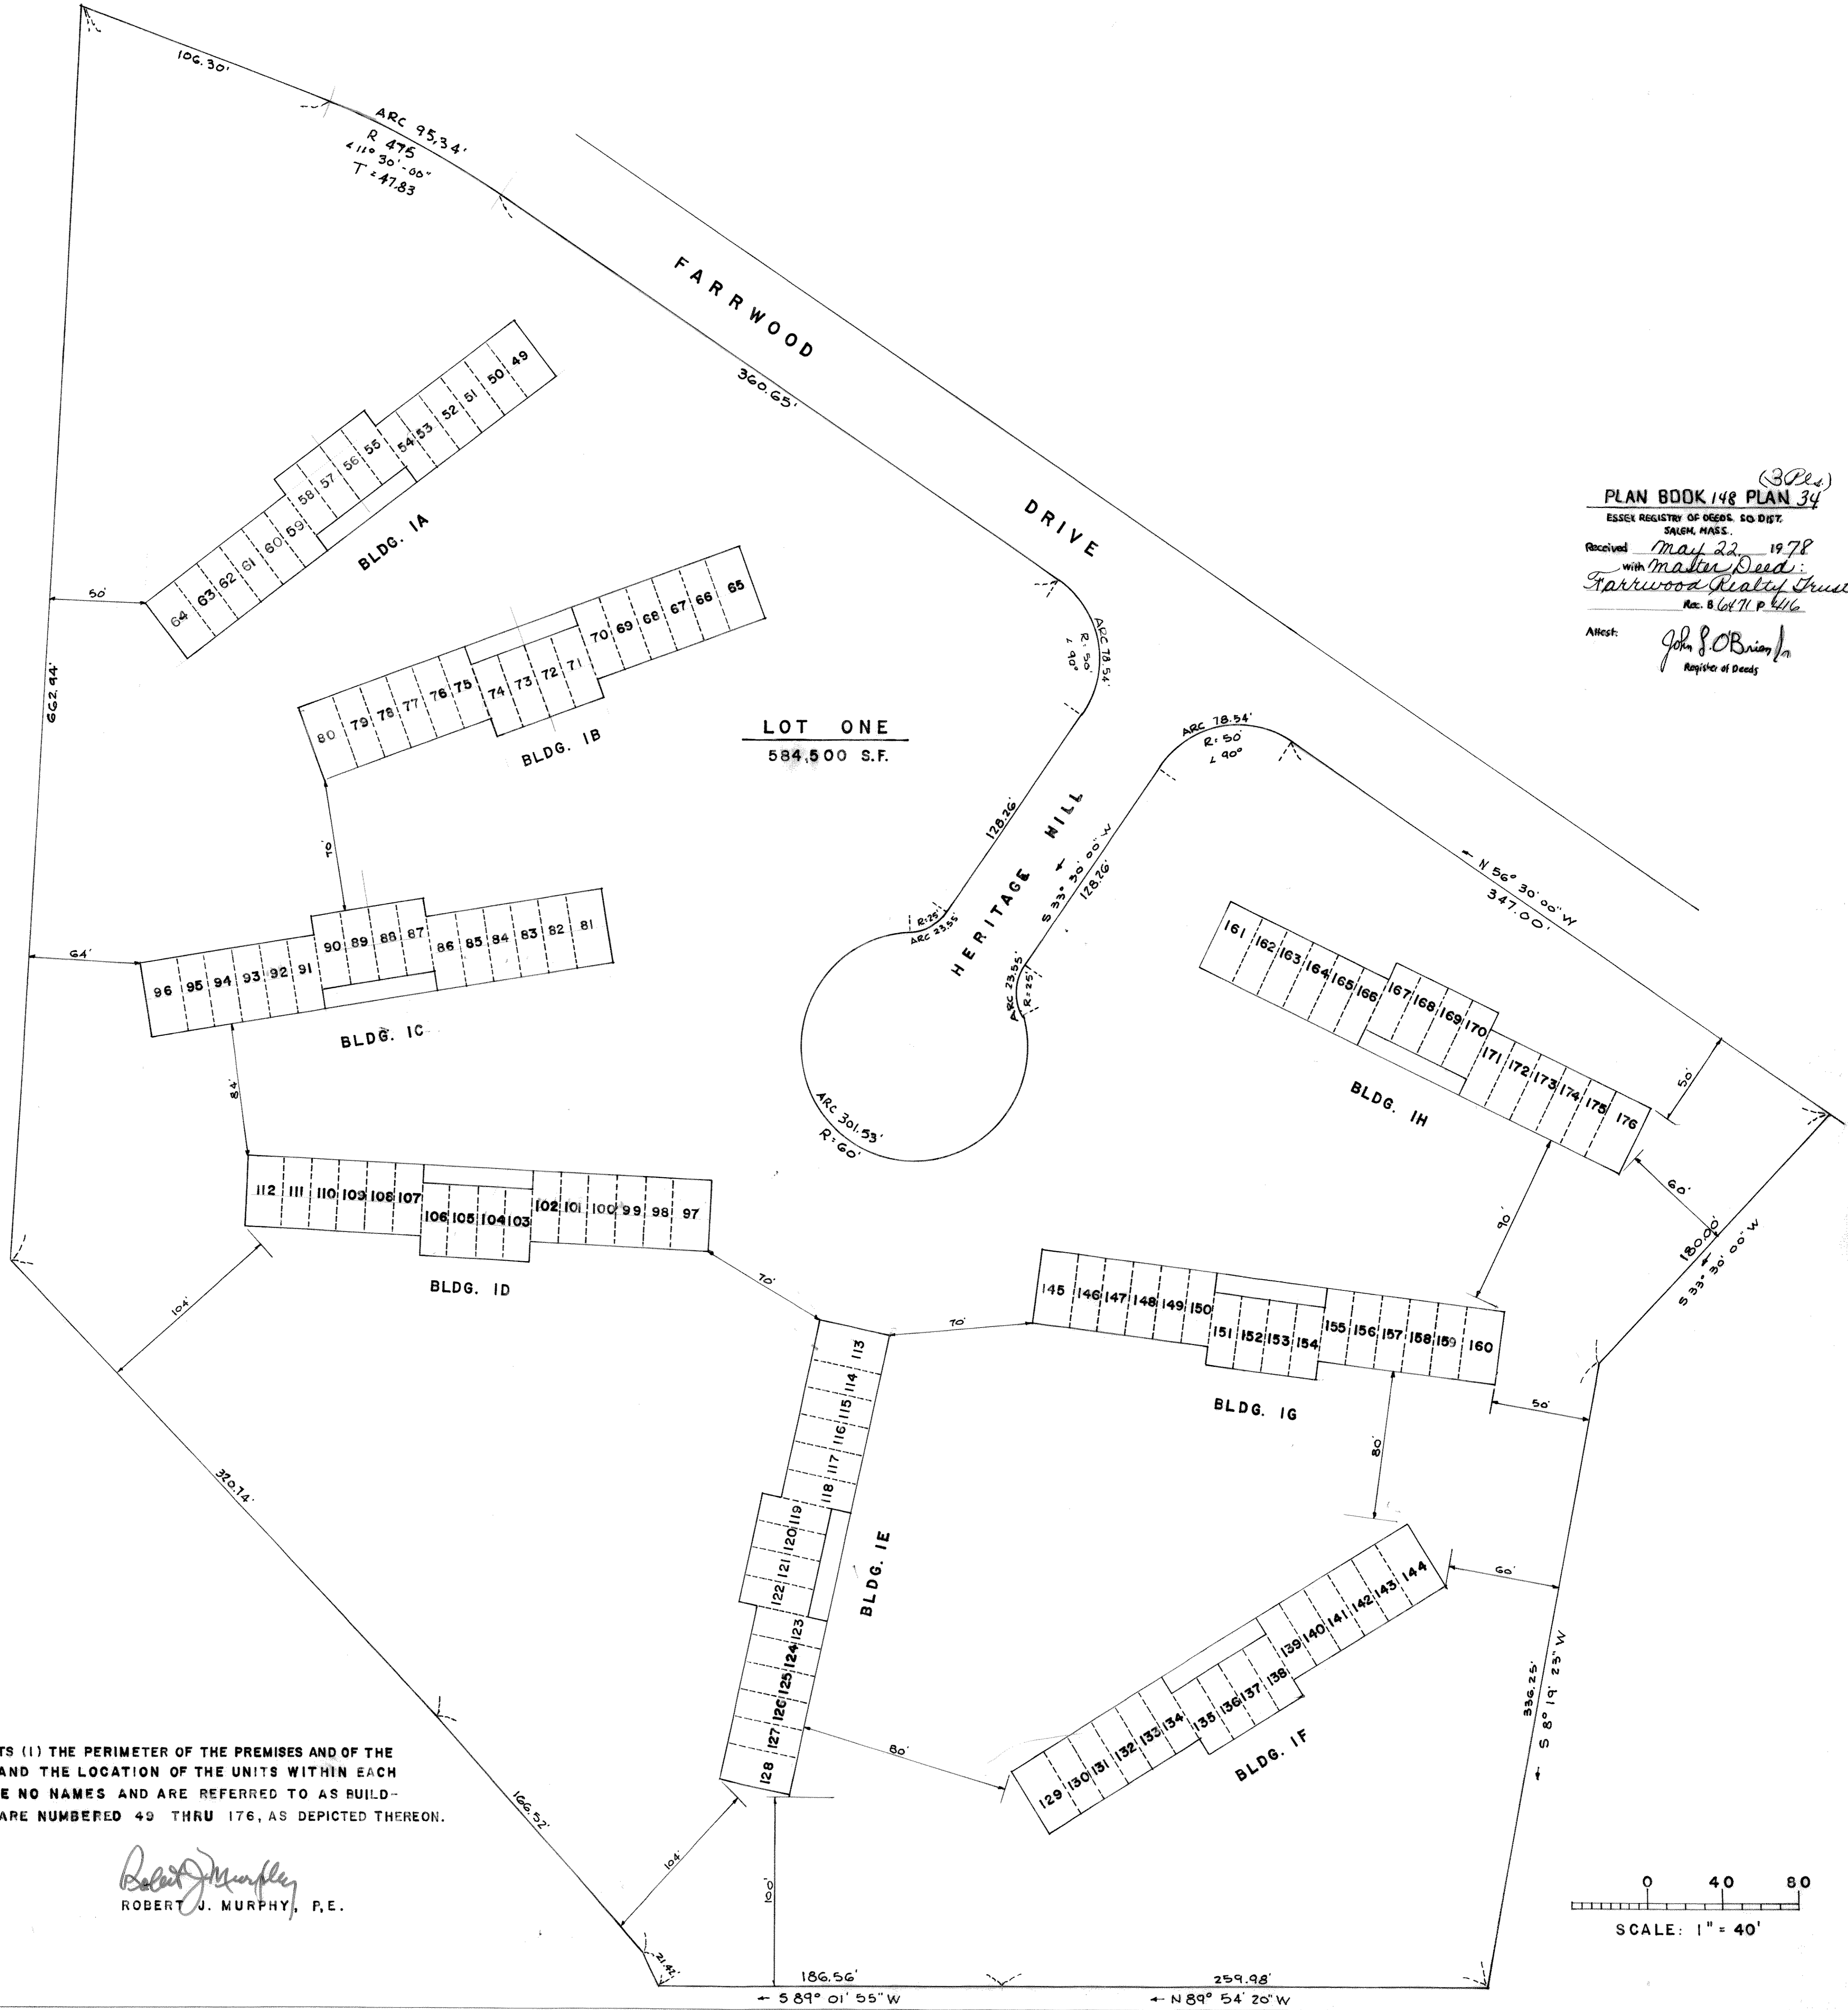

PLAN BOOK 148 (3 PLS)
 ESSEX REGISTRY OF DEEDS, 50 DIST.
 SALEM, MASS.
 Received May 22, 1978
 with Master Deed:
 Farrwood Realty Trust
 Rec. B 6471 P 416
 Attest: John J. O'Brien, Jr.
 Register of Deeds

I HEREBY CERTIFY THAT THIS PLAN FULLY AND ACCURATELY DEPICTS (1) THE PERIMETER OF THE PREMISES AND OF THE BUILDINGS AS LOCATED THEREON AND (2) THE UNIT NUMBERS AND THE LOCATION OF THE UNITS WITHIN EACH OF SAID BUILDINGS ALL AS BUILT. THE BUILDINGS HAVE NO NAMES AND ARE REFERRED TO AS BUILDINGS 1A, 1B, 1C, 1D, 1E, 1F, 1G, AND 1H; AND THE UNITS ARE NUMBERED 49 THRU 176, AS DEPICTED THEREON.

Robert J. Murphy
 ROBERT J. MURPHY, P.E.

MURPHY ASSOCIATES, INC.
 ARCHITECTS
 ENGINEERS
 477 ESSEX ST. LAWRENCE, MA.

FARRWOOD GREEN CONDOMINIUMS II
 AT BRADFORD
 HAVERHILL, MASS.

SITE PLAN
 FOR
 BUILDINGS 1A THRU 1H

SCALE AS NOTED
 DATE: MAY 4, 1978

S-1

DRAWING NO.

