



34
148

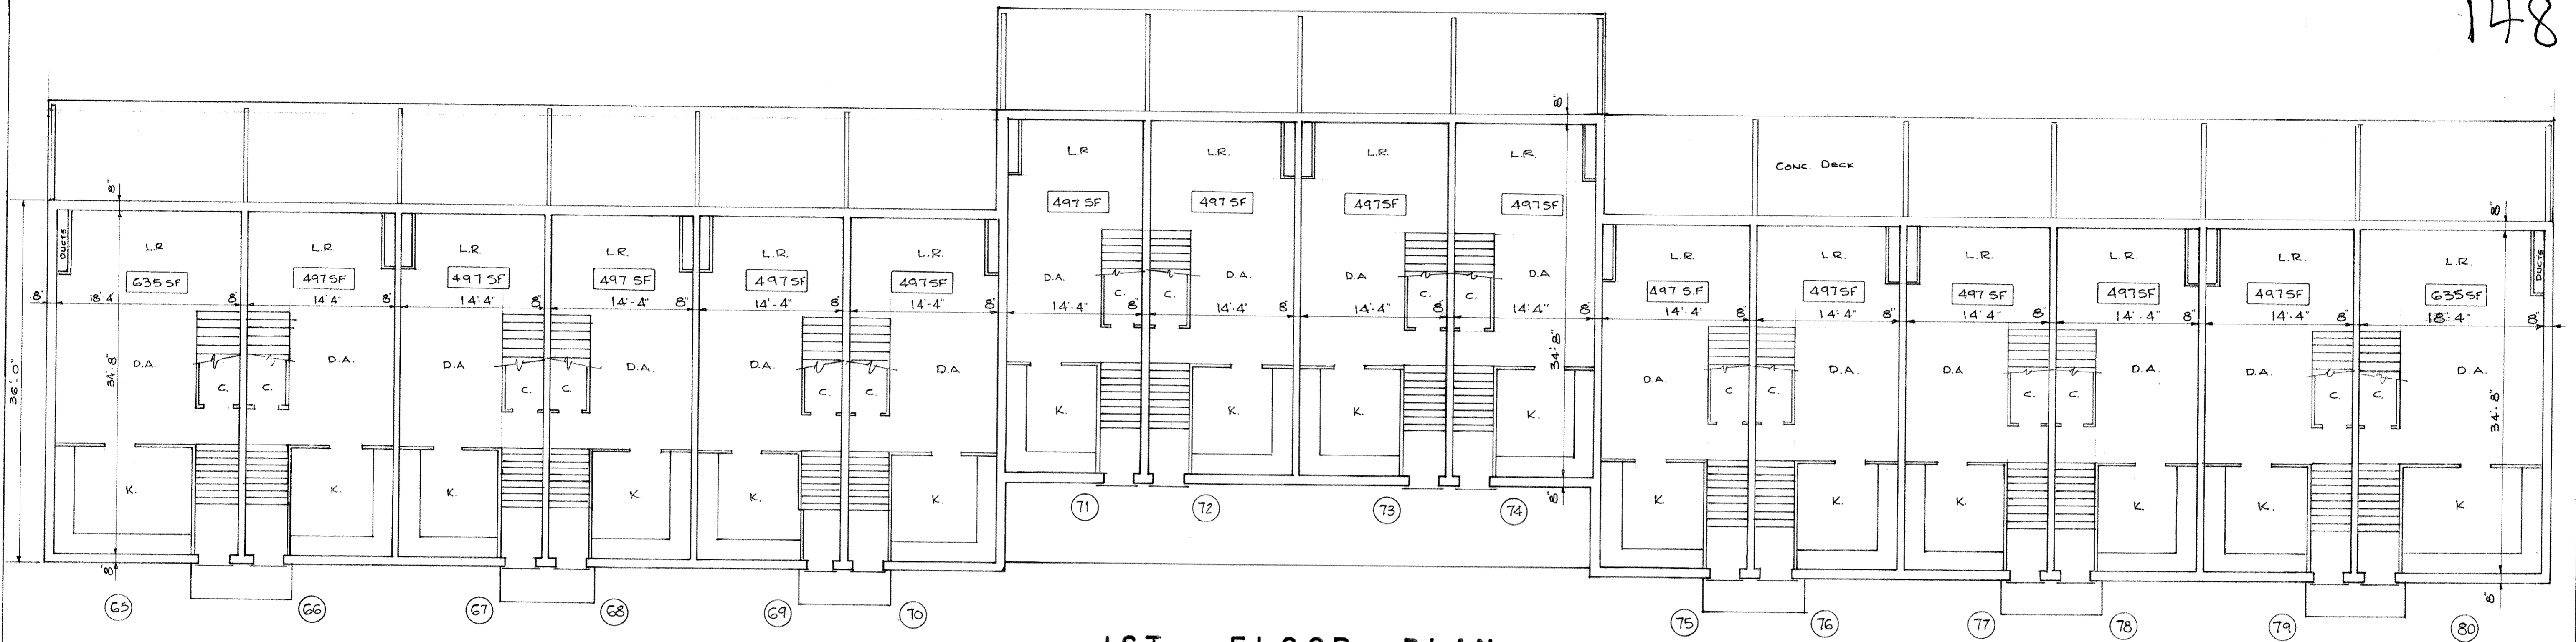

1ST FLOOR PLAN

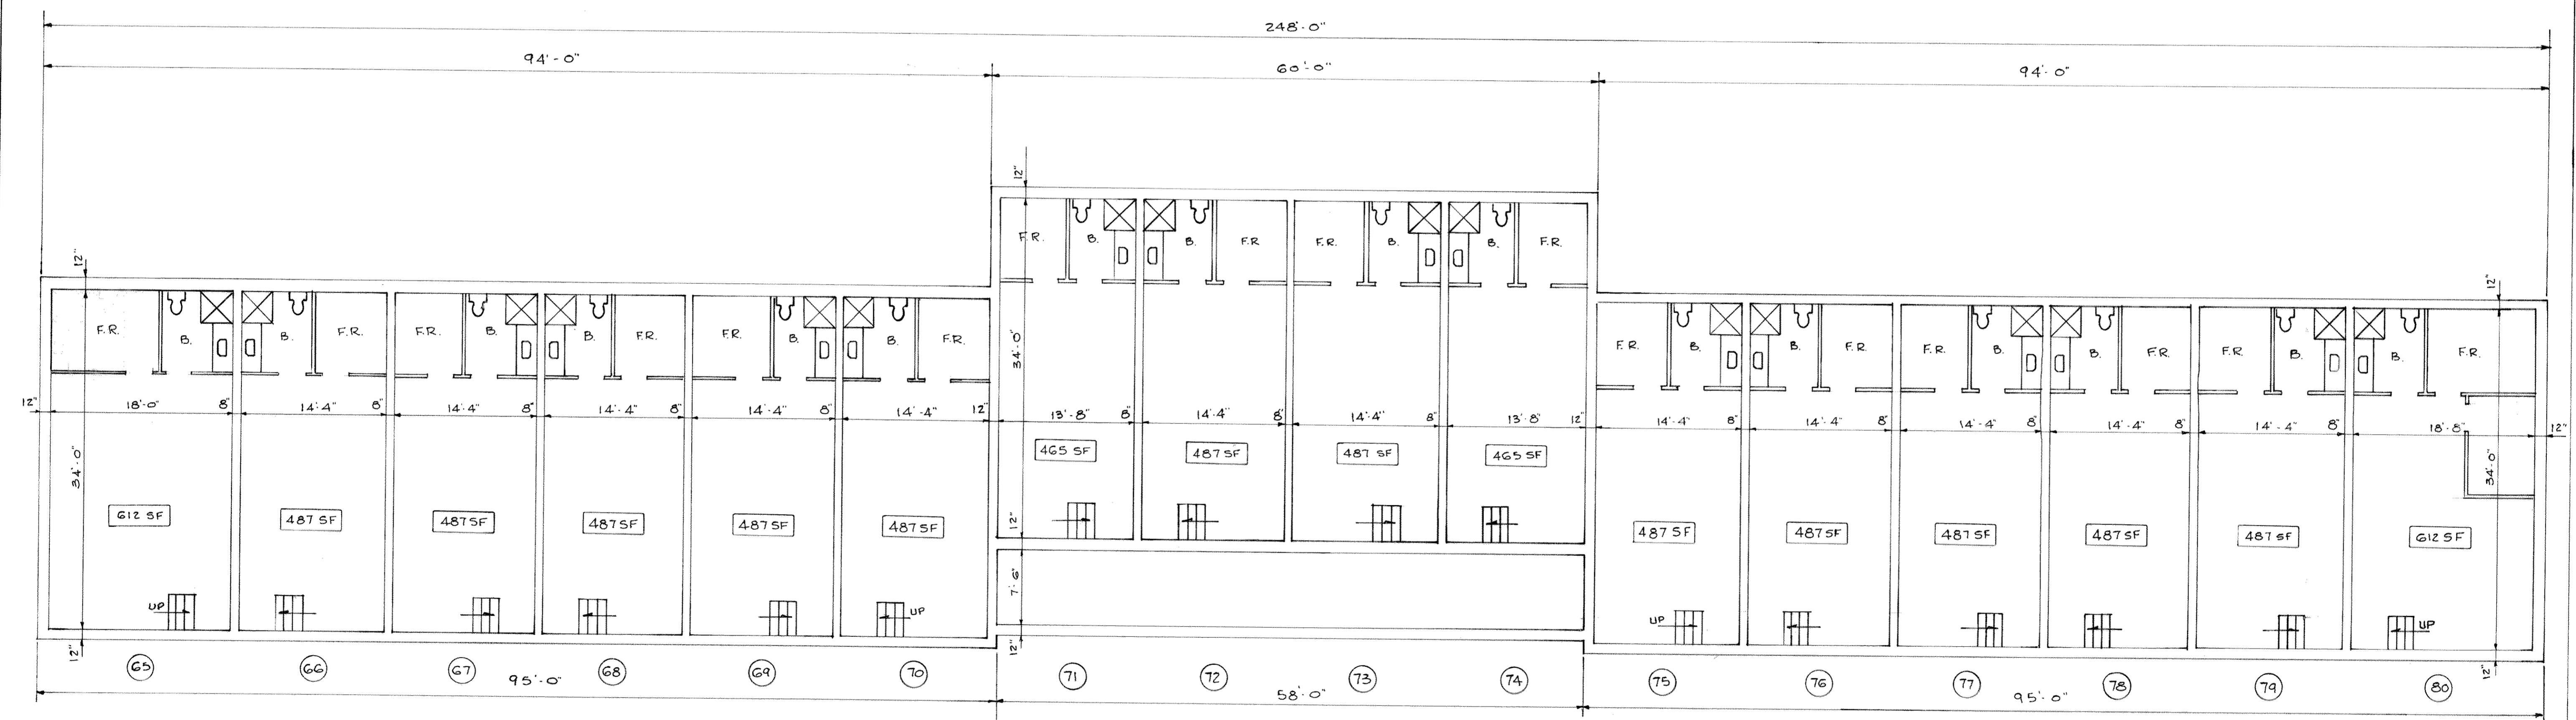


LOWER LEVEL PLAN

I HEREBY CERTIFY THAT THIS PLAN FULLY AND ACCURATELY DEPICTS THE LAYOUT, LOCATION, UNIT NUMBER AND DIMENSIONS OF THE UNITS, ALL AS BUILT. THE BUILDING HAS NO NAME BUT IS REFERRED TO AS BUILDING 1B, AND THE UNITS ARE NUMBERED 65 THRU 80, ALL AS DEPICTED HEREON.

Robert J. Murphy
ROBERT J. MURPHY, P.E.

(3 PLS)
PLAN BOOK 148 PLAN 34
ESSEX REGISTRY OF DEEDS, SO. DIST. SALEM, MASS.
Received May 22, 1978
with Match Seed:
Farrwood Realty Trust
Rec. B. 6471 P. 416
Attest: *John J. O'Brien*
Register of Deeds

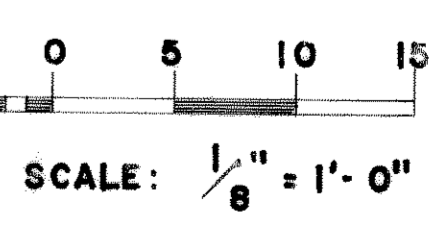

FARRWOOD GREEN CONDOMINIUMS II MURPHY ASSOCIATES, INC.
ARCHITECTS - ENGINEERS
AT BRADFORD
HAVERHILL, MASS.
477 ESSEX ST. LAWRENCE, MA.

LOWER LEVEL PLAN
1ST FLOOR PLAN
BUILDING 1B

SCALE: 1/8" = 1'-0"
DATE: MAY 4, 1978

