



34  
148

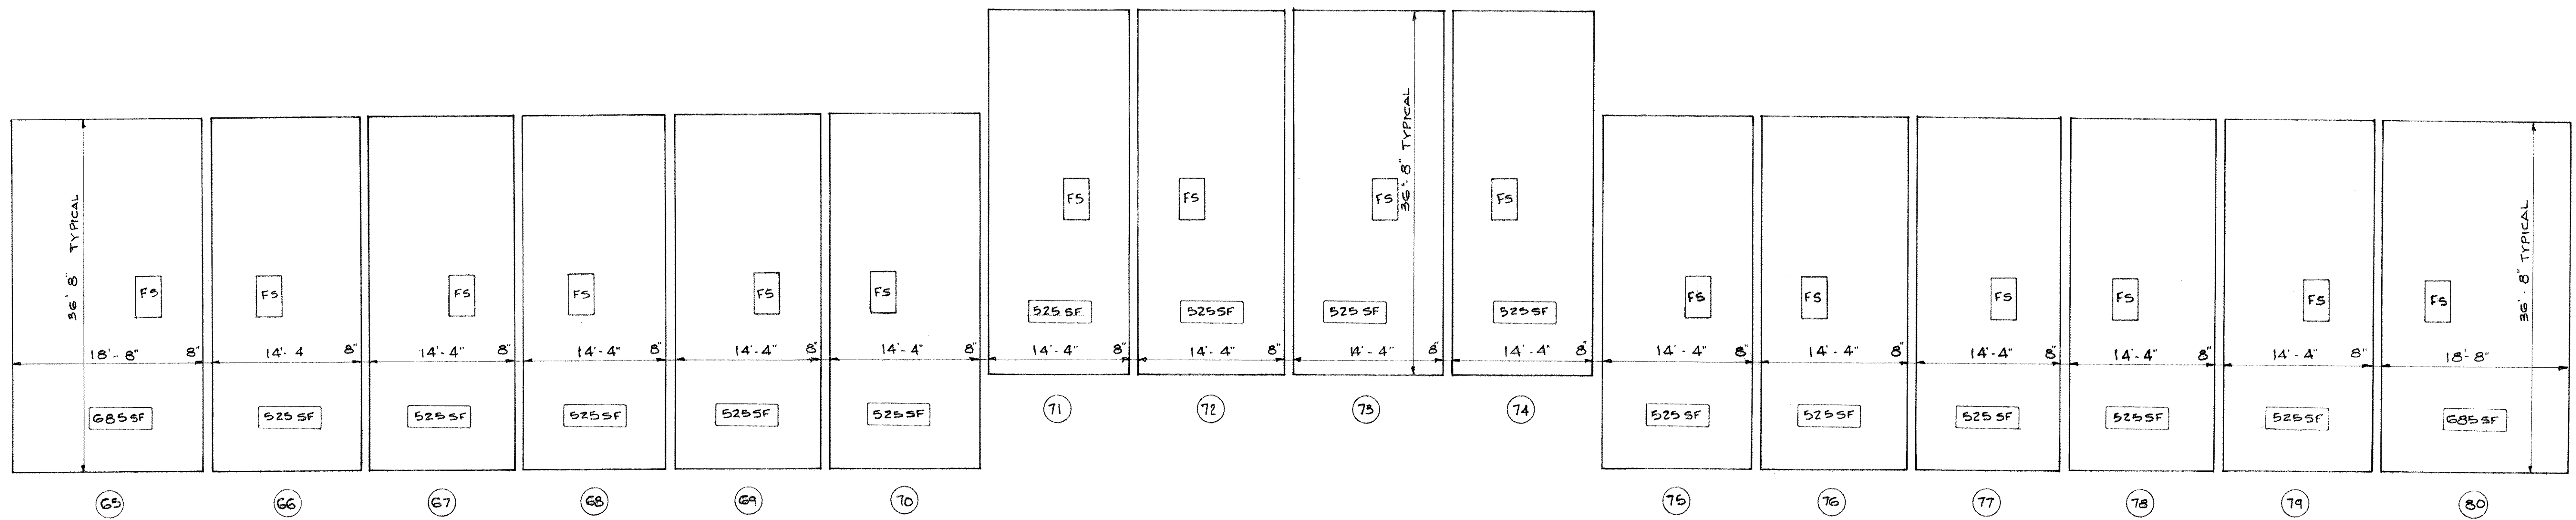

ATTIC PLAN

FS : FOLDING STAIR

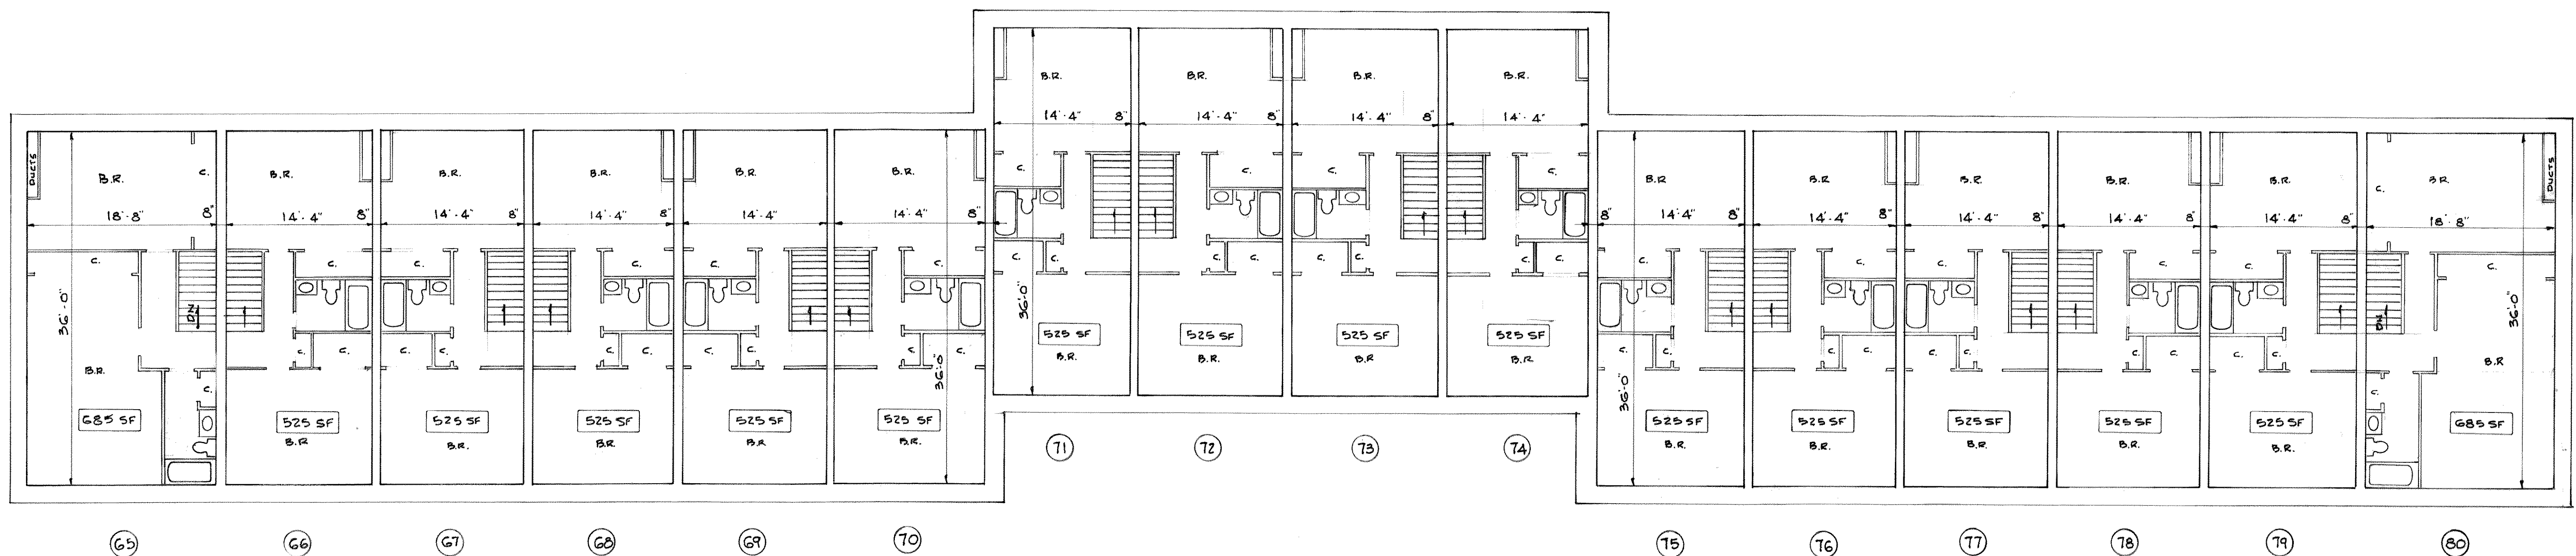

2ND FLOOR PLAN

I HEREBY CERTIFY THAT THIS PLAN FULLY AND ACCURATELY DEPICTS THE LAYOUT, LOCATION, UNIT NUMBER AND DIMENSIONS OF THE UNITS, ALL AS BUILT. THE BUILDING HAS NO NAME BUT IS REFERRED TO AS BUILDING 1B AND THE UNITS ARE NUMBERED 65 THRU 80, ALL AS DEPICTED HEREON.

*Robert J. Murphy*  
ROBERT J. MURPHY P.E.

PLAN BOOK 148 PLAN 34  
ESSEX REGISTRY OF DEEDS, SO. DIST. SALM. MASS.  
Received May 22 1978  
with Master Deed  
Farrwood Realty Trust  
Rec. 86471 P. 416  
Attest: *John P. O'Brien*  
Register of Deeds

0 5 10 15  
SCALE: 1" = 1'-0"

MURPHY ASSOCIATES, INC.  
ARCHITECTS - ENGINEERS  
477 ESSEX ST. LAWRENCE, MA.

FARRWOOD GREEN CONDOMINIUMS II  
AT BRADFORD  
HAVERHILL, MASS.

2ND FLOOR PLAN  
ATTIC PLAN  
BUILDING 1B

SCALE: 1" = 1'-0"  
DATE: MAY 4, 1978

A 2

DRAWING NO.

